



2ND FL
FA0.1.3 SCALE: NONE

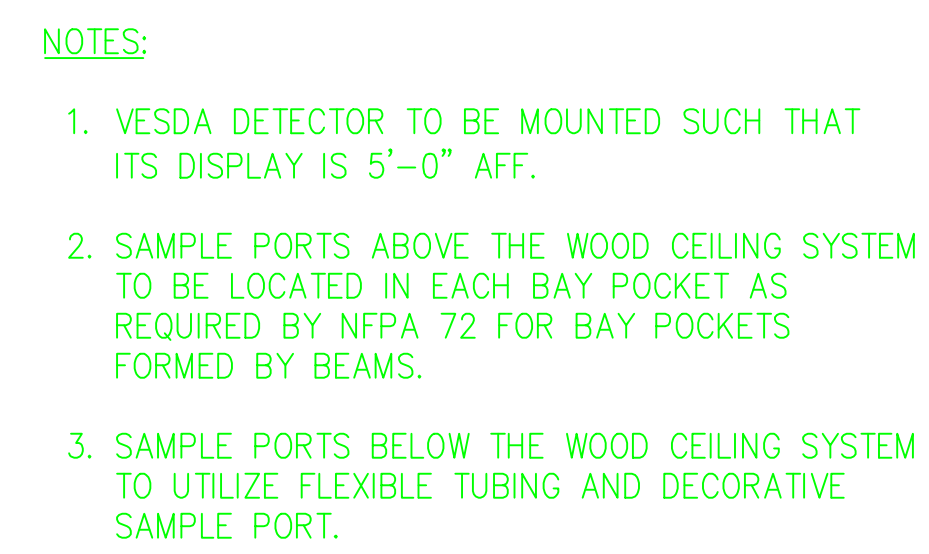

1ST FL
SCALE: NONE

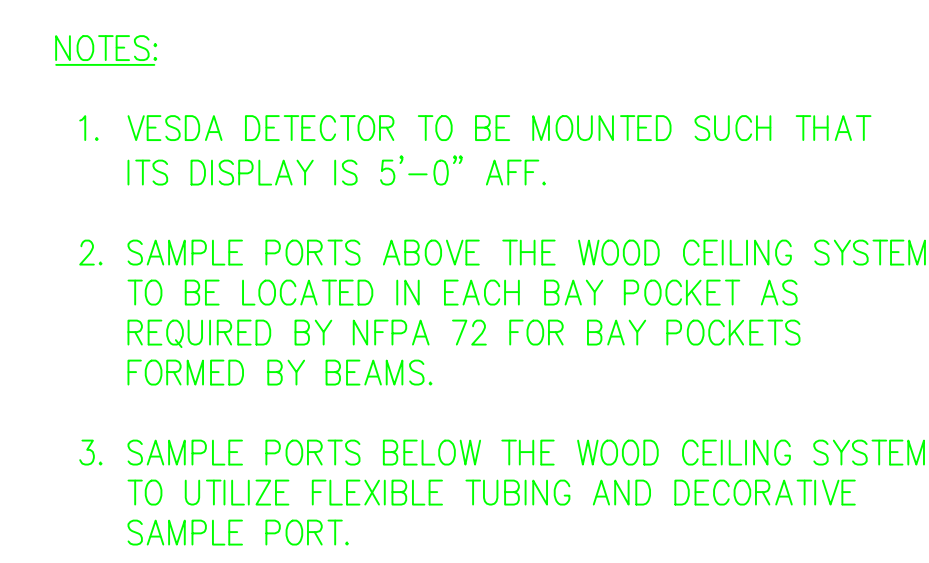

3 3RD FL
FA0.1.3 SCALE: NONE

"AS BUILT" NOTE:
REFER TO SIEMENS INDUSTRY (INSTALLATION CONTRACTOR) "AS BUILT" PLANS AND DETAILS FOR FINAL LAYOUT OF THE FIRE ALARM SYSTEMS.



vision
function
space
culture
ideas
experience


RMW think

architecture & interiors

listen
build
speak

160 Pine Street
San Francisco, CA 94111

Tel 415.781.9800
Fax 415.788.5216
www.rmw.com


HYT Corporation
Fire Protection Engineers and Consultants
3498 Clayton Road - Suite 101 Concord, California 94519
Phone: (925) 681-2731 FAX: (925) 681-2733



**LBNL *AS BUILT - SEISMIC PHASE 2
BUILDING 74
HSSD SCHEMATICS, FIRE ALARM**

UNIVERSITY OF CALIFORNIA
LAWRENCE BERKELEY NATIONAL LABORATORY
FACILITIES DIVISION

DRAWN BY HYT		DATE
CHECKED BY HYT		05/2013
APPROVED BY		
CAD FILE PATH		
SCALE As Noted		
DRAWING NO. 6N74E278_		SHEET FA0.1.3
PROJECT NO. 20090 00		